


Connection Diagram

Common 1 ① ——— ④ 4 Up
Left 2 ② ——— ⑤ 5 Right
Center 3 ③ ——— ⑥ 6 Down

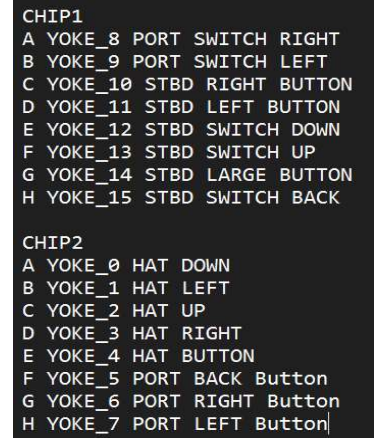

Title SimInvent FFB Yoke Wiring Diagram AS-BUILT		
Author Pete Dubler		
File C:\Users\... SimInvent FFB Yoke AS-BUILT.dsn		Document
Revision 011326b	Date 13 January 2026	Sheets 2