


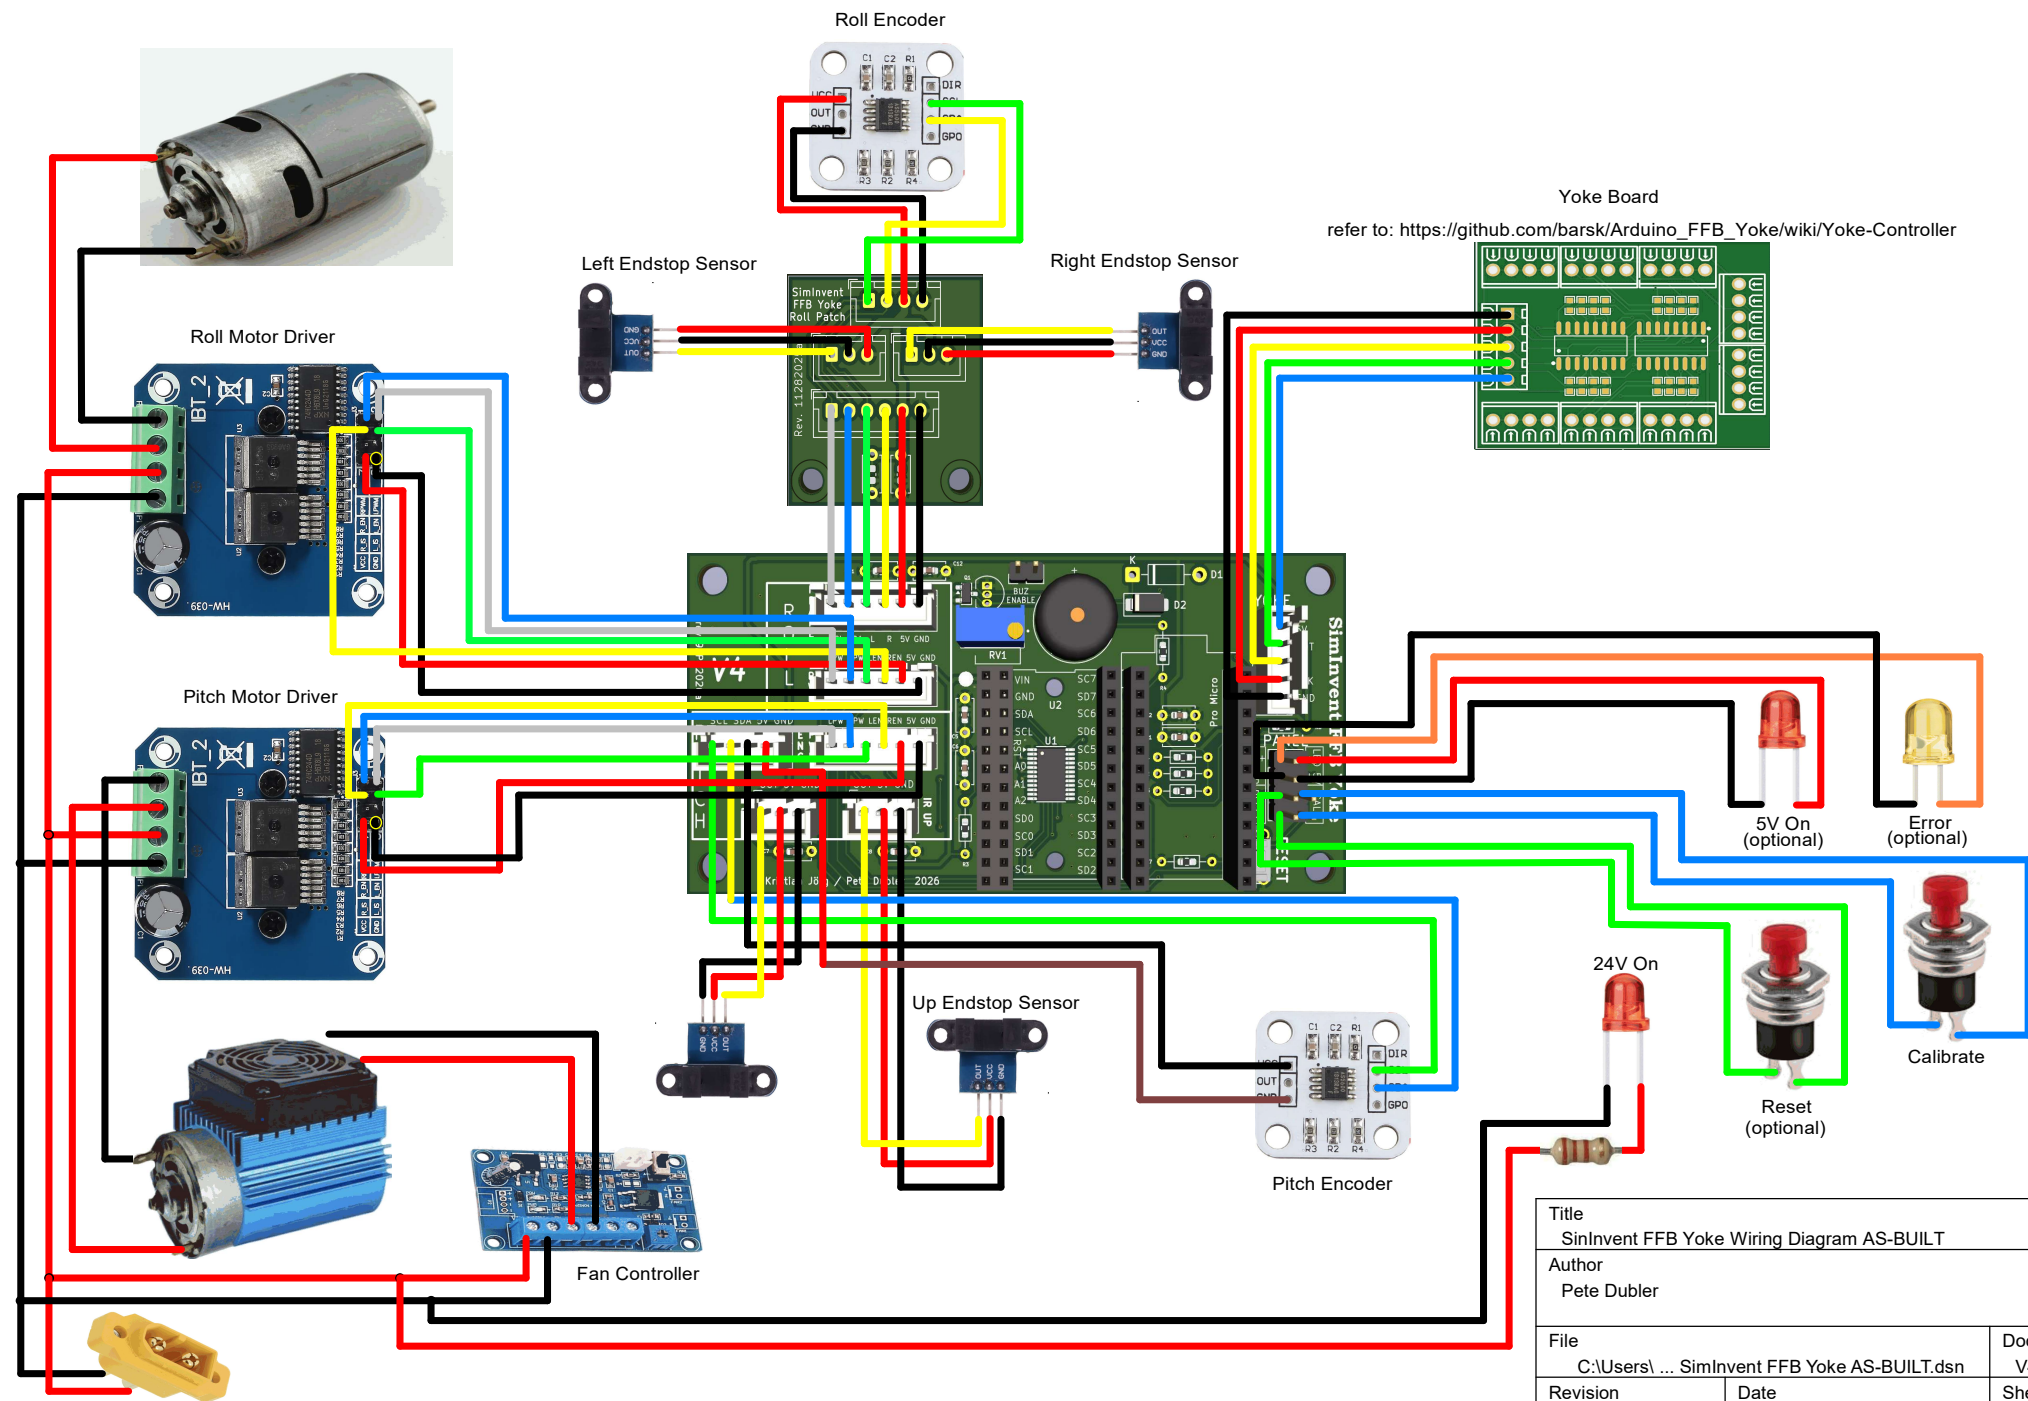

Title SinInvent FFB Yoke Wiring Diagram AS-BUILT		
Author Pete Dubler		
File C:\Users\... SinInvent FFB Yoke AS-BUILT.dsn	Document V4 board	
Revision 05152025a	Date 15 May 2025	Sheets 1 of 1