


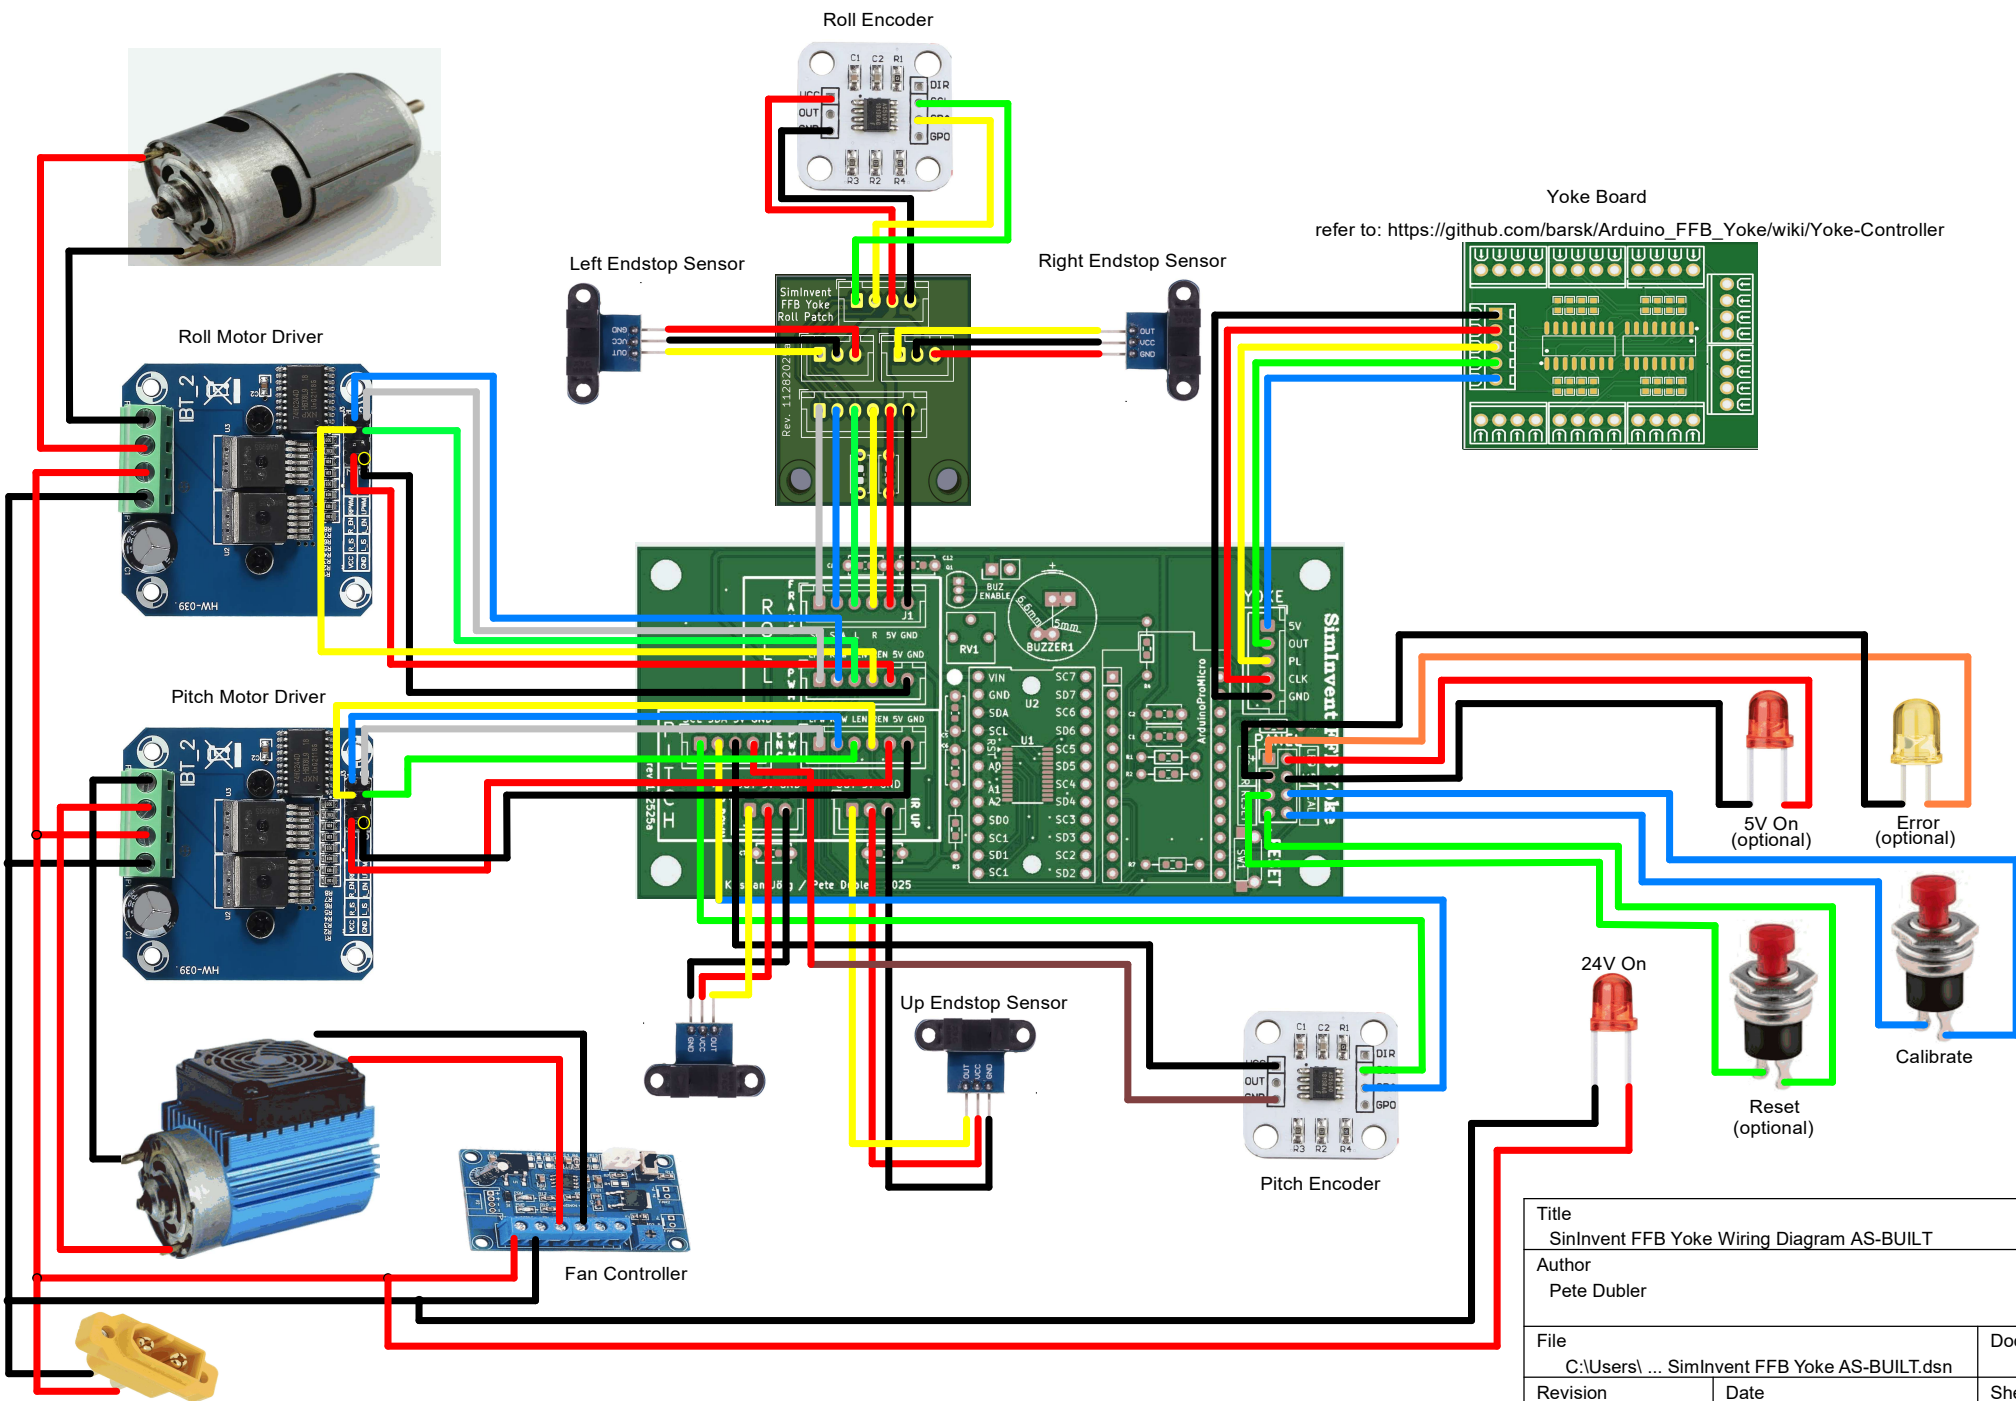

Title SinInvent FFB Yoke Wiring Diagram AS-BUILT		
Author Pete Dubler		
File C:\Users\... SinInvent FFB Yoke AS-BUILT.dsn	Document	
Revision 12132025a	Date 13 December 2025	Sheets 1 of 1